Atlantic Maritime Group FZE

AOS VENTURE

45M MAINTENANCE / UTILITY VESSEL

PRINCIPAL PARTICULARS

Length Overall:	45.00 m
Length LBP:	40.52 m
Breadth Moulded:	14.20 m
Depth Moulded:	4.50 m
Draft Max:	3.50 m
Year Built:	2018
GRT/NRT:	1182 / 354
Class:	ABS
Flag:	PANAMA
Call Sign:	HP8825

CARGO CAPACITIES

Deadweight:	342.26 T
Work Cargo Space:	200 m2
W/C Design Load:	5 T/m2
Potable Water:	161.4 m3
Ship/Cargo FO:	352.6 m3
Ballast/Drill Water:	251.3 m3
Lubricating Oil:	11.6 m3
Dirty Oil:	10.3 m3
Sewage Holding Tank:	10.7 m3
Bilge Tank:	10.3 m3

PROPULSION SYSTEM

Main Engines:	2 x 1300 BHP @ 2100 RPM CAT C32, IMO-TII, Heavy Duty
Reduction Gears:	REINTJES GMBH-LAF 675L K31A
Main Generator:	2 x Cummins, 380KW, 60Hz, 440V CCFJ380-Z-W-MYCM
Main Alternator:	2 x Leroy Somer, LSAM 47.2 M7
Shaft Generator:	2 x Leroy Somer, 600kW, 60Hz LSAM 49.3 M6
Emergency Generator:	1 x Cummins, 90kW, 60Hz, 450V CCFJ90-Y-W-MYCM Alternator: LSAM 44.3 S5
Bow Thruster:	1 x 6T CPP – CAT MTT 113 CL-02
Propellers:	2 x CPP – CAT – MPP 490, 4 Blades
Rudders:	2 x High Lift Flap Spade Type
Steering Gear:	2 JASTRAM Electro Hydraulic Independent Type, Twin S2-40-1-35
Maintenance Compressors:	2 x RENNER RSF-132 / 22230 L/min or 785 ft3/min @ 8.50 Bar
Compressed Air Dryer:	1 x Buran Donaldson 1175 m3/hr @ Maximum 1.60 Mpa

PERFORMANCE

Maximum Speed:	
Economical Speed:	10.0 knots, 85% MCR

SPECIFICATIONS ARE NOT CONTRACTUAL AND SUBJECT TO CHANGE WITHOUT PRIOR NOTICE.

DECK EQUIPMENT

Windlass:	1 MacGregor x 5 T @ 9.0m/min
Anchors:	2 x 1255 Kg
Chains:	Total of 660m x 30 mm
Capstan:	2 x 5T @ 15 m/min
Tugger Winch:	2 x 5T @ 10 m/min
Deck Crane:	1 MacGregor x Electro Hydraulic
	SWL: 20 T @ 4m Working Radius
	4 T @ 20 m Working Radius
	30 m Boom Extension

RADIO AND NAVIGATION

GMDSS (A1+A2+A3)	FURUNO FS-2575
Radar:	1 Furuno x FAR-2117-D, X Band
Radar:	1 Furuno x FAR-2137-D, S Band
GPS:	2 Furuno x GP-170
Echo Sounder:	1 Furuno x FE-800
Navtex:	1Furuno x NX-700A
Auto-Pilot:	1 Anschutz x NP 60
Gyro Compass:	1 Anschutz x Standard 22
Inmarsat -C:	1 Furuno x Felcom 18
Speed Log:	1 Furuno x DS-60
SART:	2 Ocean Signal x S100
EPIRB:	1 Ocean Signal x E100
AIS:	1 Fruruno x FA-170
Port. GMDSS VHF:	3 Icom x IC-GM 1600
Weather Fax:	1 Furuno x FAX-408
Portable VHF:	3 x Motorola GP328
BNWAS:	1 x Furuno BR 500
Chart Plotter:	1 x Garmin GPSMAP7412

LIFE SAVING & HSE

Search Lights:	2 x 2,000w & 2 x 1,000w
Floodlights:	6 x 500W
Life Rafts:	6 x 20 Men
Lifejackets:	38 Nos.
Lifebuoys:	8 Nos.
Rescue Boats:	1 x Rescue Boat, 6 PAX

DISCHARGE RATES

FW Cargo Pump:	90 m m3/hr @ 30m head
FO Cargo Pump:	92 m3/hr @ 38.2 m head
Dirty Oil/Sludge Pump:	5 m3/hr @ 45 m head
Fire/GS/Bilge/Ballast pump:	2 x 80 m3 @ 60 m head
Bilge Pump:	2 x 35 m3/hr @ 25 m head
	1 x 2 m3/hr @ 25 m head
Emergency Fire Pump:	1 x 35 m3/hr @50 m head

ACCOMMODATION

Configuration:	
Single Cabin:	1 Man x 4
Twin Cabin:	2 Men x 15
Total:	34 Men

Accommodation is fully air conditioned.

GALLEY & LAUNDRY

Electric Cooking Range:	1 x 4 Hot Plates
Refrigerator Capacity:	300 Litres
Freezer/Chiller Room Capacity:	11.5 m3 / 12.5 m3
Electric Water Boilers:	2 x 30 Litres
Washing Machines:	3 x 10 Kgs
Dryers:	3 x 10 Kgs
Fodable Iron:	1 with Ironing Table

FIRE-FIGHTING

1 x CO2 System: Engine Room, Paint Locker and Galley

MISCELLANEOUS

Sewage Treatment:	1 x Treatment Plant for 40 Men
	Sewage Discharge pump 53.0 m3/hr
Oily Water Separator:	1.0 m3/hr
Freshwater Maker:	1 Set / 8 T Per Day

Main & Emergency Switch Boards

(Include PMS): **SAIERNICO**

Atlantic Maritime Group FZE

SPECIFICATIONS ARE NOT CONTRACTUAL AND SUBJECT TO CHANGE WITHOUT PRIOR NOTICE.

FOCAL 551
45M MUV

REVIEWED

Details of this review are as indicated in the ABS letter

ABS

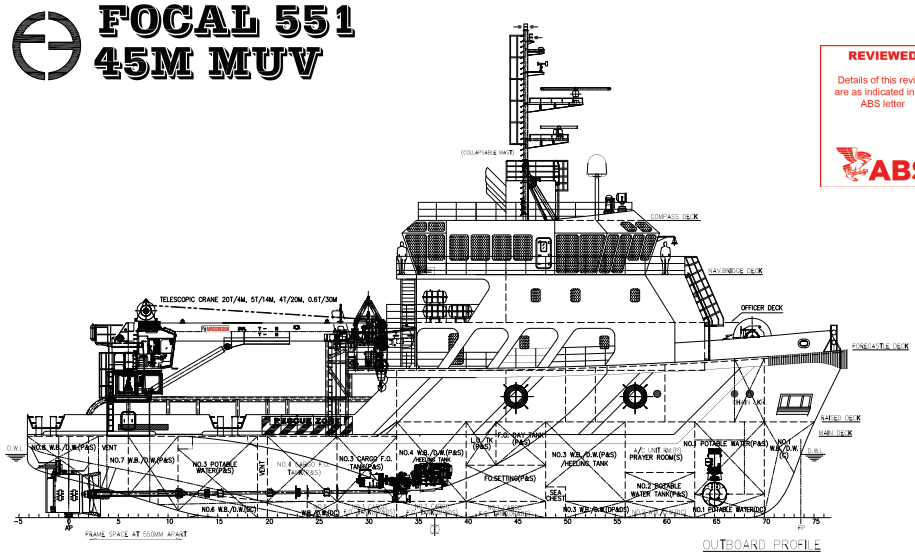

OUTBOARD PROFILE

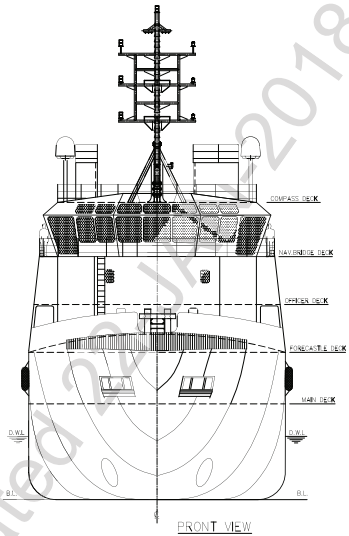

FRONT VIEW

PRINCIPAL PARTICULARS & CAPACITIES

LENGTH OA	45.00M
LENGTH BP	40.52M
BEAM MLD.	14.20M
DEPTH MLD.	4.50M
DRAFT SCANTLING	3.50M
DRAFT DESIGNED	3.20M
COMPLEMENT	34 MEN
MAIN ENGINE	2 x 1,300 BHP
DECK LOADING	5T/M^2
TRIAL SPEED	10.5 KTS
CARGO DECK AREA	200 M^2
FUEL OIL	350 M^3
W.B./D.W.	250 M^3
POTABLE WATER	160 M^3

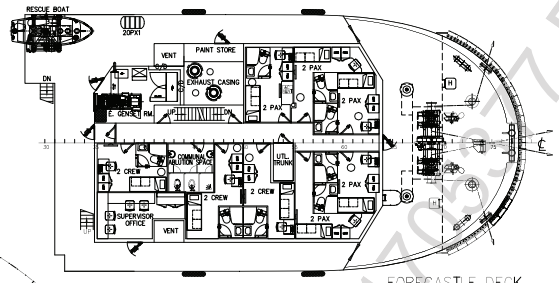

FORECASTLE DECK
(16 MEN)

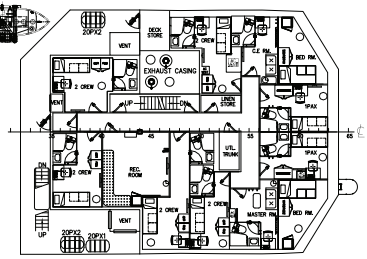

OFFICER DECK
(14 MEN)

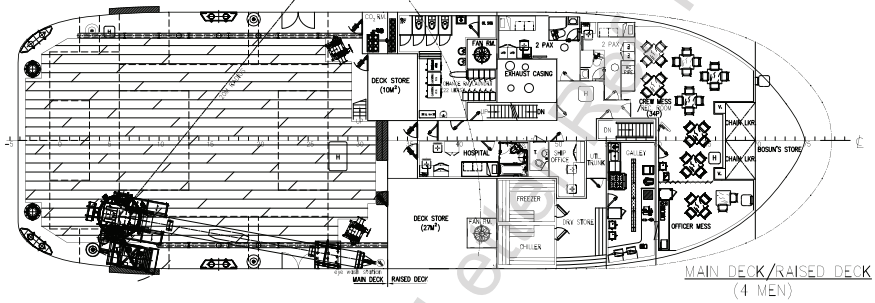

MAIN DECK/RAISED DECK
(4 MEN)

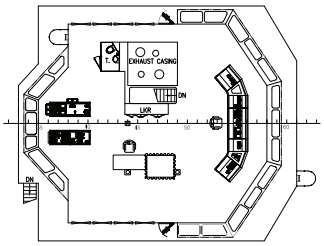

NAV. BRIDGE DECK

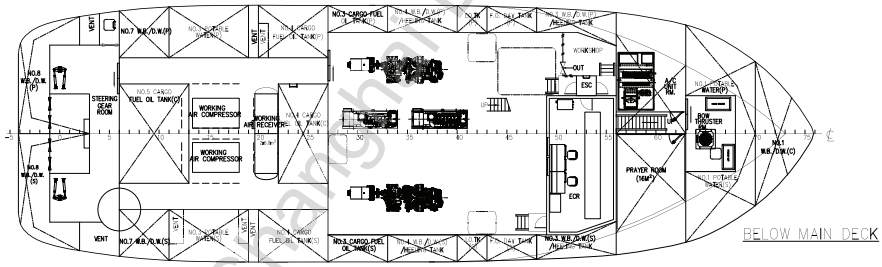

BELOW MAIN DECK

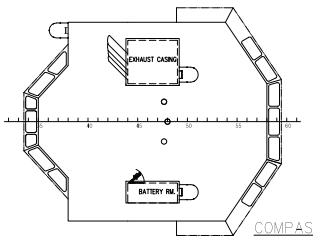

COMPASS DECK

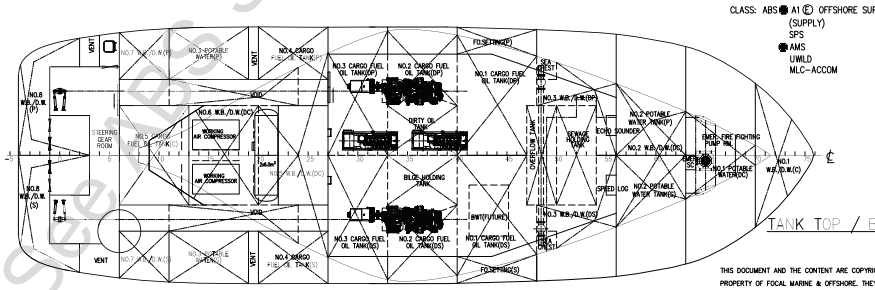

TANK TOP / BOTTOM

CLASS: ABS ✠ A1 Ⓔ OFFSHORE SUPPORT VESSEL
(SUPPLY)
SPS
✠ AMS
UWLD
MLC-ACCOM

THIS DOCUMENT AND THE CONTENT ARE COPYRIGHT AND REMAIN PROPERTY OF FOCAL MARINE & OFFSHORE. THEY MUST NOT BE COPIED IN WHOLE OR IN PART TO ANY THIRD PARTY FOR ANY PURPOSE WITHOUT PRIOR WRITTEN PERMISSION FROM FOCAL MARINE & OFFSHORE. THE RECEIPT OF THIS DOCUMENT IMPLIES ACCEPTANCE OF THIS CONDITION.

REV NO.	REVISION DESCRIPTION	BY	DATE
9	AMENDED AS BUILT ON SITE	ZF	DEC-28-2017
8	AMENDED AS DESIGN PROGRESS	YP	SEP-30-2016

OWNER: ATLANTIC MARITIME GROUP FZE

BUILDER: WUCHANG SHIPBUILDING INDUSTRY CO., LTD
HULL NO.: BG0012A09M/BG0013A09M/BG0014A09M/BG0015A09M

PROJECT: 45M MAINTENANCE / UTILITY VESSEL "FOCAL 551"

APPROVE		DWG TITLE: GENERAL ARRANGEMENT	JOB NO.: P-1919
VERIFY			DWG NO.: P-1919-G01
CHECKER			SCALE : 1:125 (A1)
DRAWER	YP		CLASS : ABS

FOCAL MARINE & OFFSHORE
EMAIL: info@focalmarine.com
SHANGHAI TEL: 86-21-58705786 FAX: 86-21-50313265
SINGAPORE TEL: 65-68481387 FAX: 65-68481291

See ABS Shanghai Letter No. T170837 Dated 24 JAN 2018